

United
Consultants, Inc.

850 Franklin Street Suite 11D
Wrentham, MA 02093
508-384-6560 FAX 508-384-6566

October 27, 2020

Wrentham Conservation Commission
79 South Street
Wrentham, MA 02093

Re: DEP File # 351-1146

Dear Commission Members:

We respectfully request a partial Certificate of Compliance for the work in the 0 – 50' buffer zone.

The Phase I As-Built Plan dated October 27, 2020 reflects the changes from the originally approved site plan dated May 20, 2020.

After review of the proposed site plan and the as-built plan the following was observed.

An underground storage/infiltration area has been constructed in lieu of the open rain garden.

The project as constructed is within the approved limit of work.

The work shown on the as-built plan has been performed within substantial compliance with the approved site plan.

Should you have any questions, please do not hesitate to contact me.

Sincerely,



Carlos A. Quintal, P.E.





Massachusetts Department of Environmental Protection
 Bureau of Resource Protection - Wetlands
WPA Form 8A – Request for Certificate of Compliance
 Massachusetts Wetlands Protection Act M.G.L. c. 131, §40

DEP File Number:
351-1146
 Provided by DEP

A. Project Information

Important:
 When filling out forms on the computer, use only the tab key to move your cursor - do not use the return key.

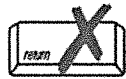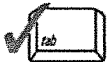

Upon completion of the work authorized in an Order of Conditions, the property owner must request a Certificate of Compliance from the issuing authority stating that the work or portion of the work has been satisfactorily completed.

1. This request is being made by:
Carol Embree, North Hollow LLC
 Name
15 Welcome Lane
 Mailing Address
Wrentham **MA** **02093**
 City/Town State Zip Code
 Phone Number

2. This request is in reference to work regulated by a final Order of Conditions issued to:
Carol Embree, North Hollow LLC
 Applicant
6/4/2020 **351-1146**
 Dated DEP File Number

3. The project site is located at:
5 Welcome Lane **Wrentham**
 Street Address City/Town
Map K-09 Block 9 **Lot 13**
 Assessors Map/Plat Number Parcel/Lot Number

4. The final Order of Conditions was recorded at the Registry of Deeds for:
Carol Embree, North Hollow LLC
 Property Owner (if different)
Norfolk **37976** **77**
 County Book Page
37976 **88**
 Certificate (if registered land)

5. This request is for certification that (check one):

the work regulated by the above-referenced Order of Conditions has been satisfactorily completed.

the following portions of the work regulated by the above-referenced Order of Conditions have been satisfactorily completed (use additional paper if necessary).
Reconstruction of the wall along the lake, construction of an infiltration/storage system for stormwater and landscaping.

The work performed was in the 0 - 50' buffer zone.

the above-referenced Order of Conditions has lapsed and is therefore no longer valid, and the work regulated by it was never started.



Massachusetts Department of Environmental Protection
Bureau of Resource Protection - Wetlands
WPA Form 8A – Request for Certificate of Compliance
Massachusetts Wetlands Protection Act M.G.L. c. 131, §40

DEP File Number:

Provided by DEP

A. Project Information (cont.)

6. Did the Order of Conditions for this project, or the portion of the project subject to this request, contain an approval of any plans stamped by a registered professional engineer, architect, landscape architect, or land surveyor?


Yes If yes, attach a written statement by such a professional certifying substantial compliance with the plans and describing what deviation, if any, exists from the plans approved in the Order.

No


B. Submittal Requirements

Requests for Certificates of Compliance should be directed to the issuing authority that issued the final Order of Conditions (OOC). If the project received an OOC from the Conservation Commission, submit this request to that Commission. If the project was issued a Superseding Order of Conditions or was the subject of an Adjudicatory Hearing Final Decision, submit this request to the appropriate DEP Regional Office (see <http://www.mass.gov/dep/about/region/findyour.htm>).

PB498
PLAN 453 of 2002

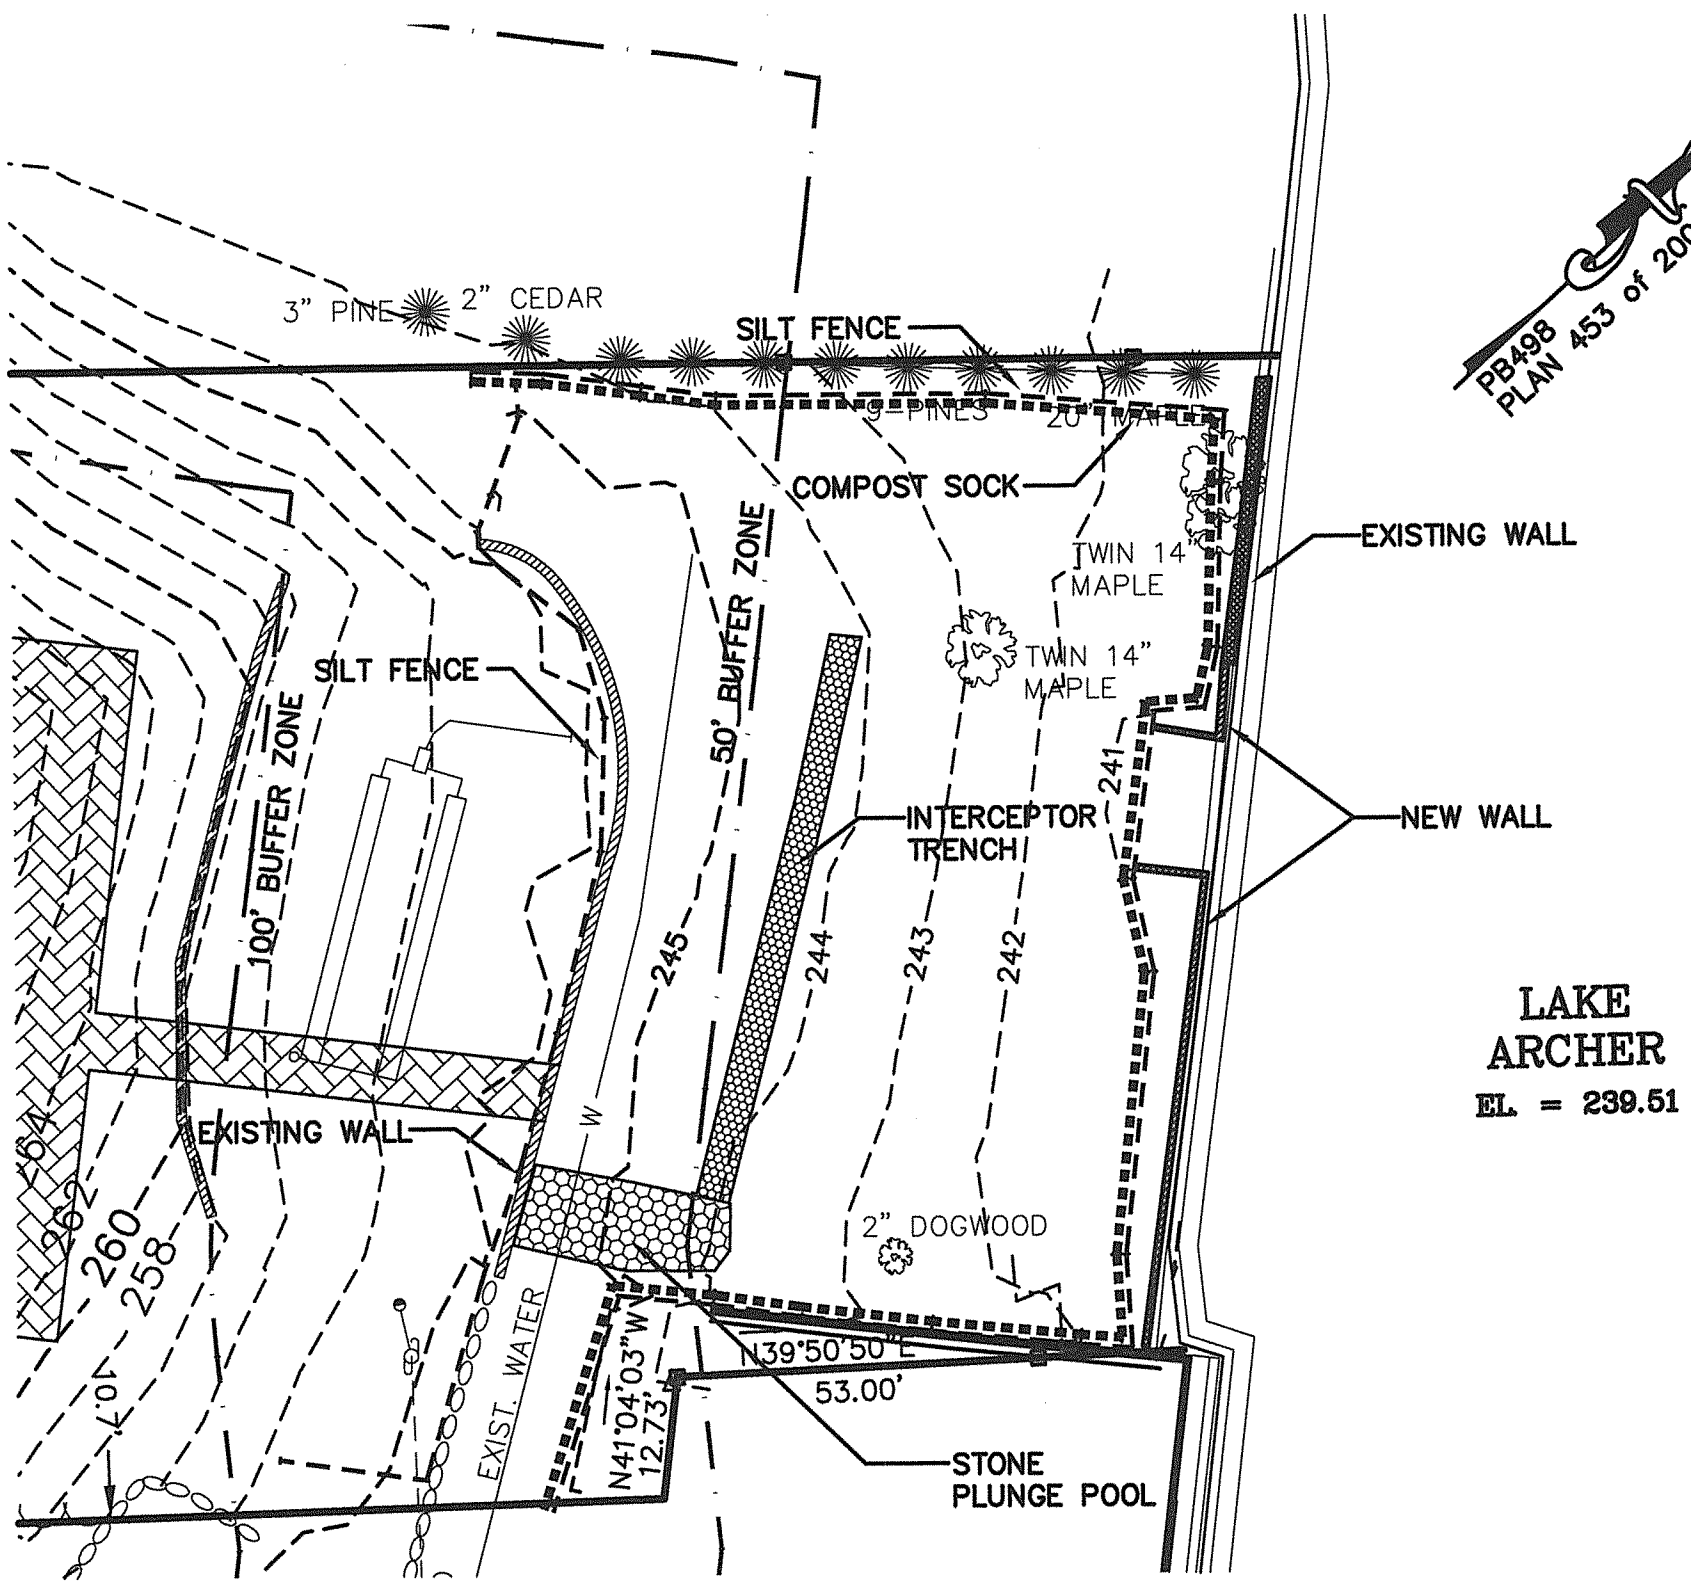

LAKE
ARCHER
EL. = 239.51

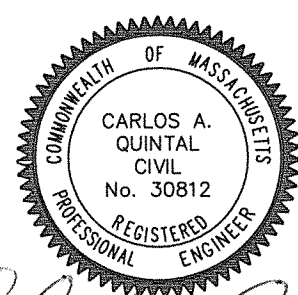

Carlos A. Quintal
CARLOS A. QUINTAL P.E. #30812

SCALE: 1" = 20'	PROJECT: UC 1434
DATE: OCTOBER 27, 2020	
OWNER: PAUL EMBREE 15 WELCOME LANE WRENTHAM, MASSACHUSETTS	

PHASE 1 ASBUILT
5 WELCOME LANE
WRENTHAM, MA

**UNITED
CONSULTANTS
INC.**
850 FRANKLIN STREET SUITE 11D
WRENTHAM, MASSACHUSETTS 02093
508-384-8580 FAX 508-384-8588