

United
Consultants, Inc.
850 Franklin Street Suite 11D
Wrentham, MA 02093
508-384-6560 FAX 508-384-6566

RECEIVED
JAN 14 2021
WRENTHAM
CONSERVATION COMMISSION

January 6, 2021

Wrentham Conservation Commission
79 South Street
Wrentham, MA 02093

Re: DEP File # 351-1142

Dear Commission Members:

We respectfully request a Certificate of Compliance for the work performed at 137 Gilmore Road.

The As-Built Plan dated January 6, 2021 reflects the changes from the originally approved site plan dated April 2, 2020.

After review of the proposed site plan and the as-built plan the following was observed.

An underground storage/infiltration area has been constructed in lieu of the open rain garden.

The lawn area has been reduced and replaced by mulched planting beds.

The patio and wall have been relocated approximately 2' further away from the lake.

A total of 6 trees and 33 shrubs have been planted.

The project as constructed is within the approved limit of work.

The work shown on the as-built plan has been performed within substantial compliance with the approved site plan.

Should you have any questions, please do not hesitate to contact me.

Sincerely,


Carlos A. Quintal, P.E.




Massachusetts Department of Environmental Protection
 Bureau of Resource Protection - Wetlands
WPA Form 8A – Request for Certificate of Compliance
 Massachusetts Wetlands Protection Act M.G.L. c. 131, §40

DEP File Number:
351-1142
 Provided by DEP

A. Project Information

Important:
 When filling out forms on the computer, use only the tab key to move your cursor - do not use the return key.

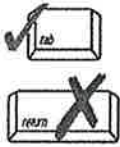

Upon completion of the work authorized in an Order of Conditions, the property owner must request a Certificate of Compliance from the issuing authority stating that the work or portion of the work has been satisfactorily completed.

1. This request is being made by:

Carol Felix

Name

137 Gilmore Road

Mailing Address

Wrentham

City/Town

MA

State

02093

Zip Code

Phone Number

2. This request is in reference to work regulated by a final Order of Conditions issued to:

Carol Felix

Applicant

4/17/2020

Dated

351-1142

DEP File Number

3. The project site is located at:

137 Gilmore Road

Street Address

Map K-10 Block 1

Assessors Map/Plat Number

Wrentham

City/Town

Lot 13

Parcel/Lot Number

4. The final Order of Conditions was recorded at the Registry of Deeds for:

Carol Felix

Property Owner (if different)

Norfolk

County

37791

Book

37791

472

Page **479**

Certificate (if registered land)

5. This request is for certification that (check one):

the work regulated by the above-referenced Order of Conditions has been satisfactorily completed.

the following portions of the work regulated by the above-referenced Order of Conditions have been satisfactorily completed (use additional paper if necessary).

the above-referenced Order of Conditions has lapsed and is therefore no longer valid, and the work regulated by it was never started.

RECEIVED

JAN 14 2021

**WRENTHAM
 CONSERVATION COMMISSION**



WPA Form 8A – Request for Certificate of Compliance

Massachusetts Wetlands Protection Act M.G.L. c. 131, §40

Provided by DEP

A. Project Information (cont.)

6. Did the Order of Conditions for this project, or the portion of the project subject to this request, contain an approval of any plans stamped by a registered professional engineer, architect, landscape architect, or land surveyor?

Yes If yes, attach a written statement by such a professional certifying substantial compliance with the plans and describing what deviation, if any, exists from the plans approved in the Order.


No

B. Submittal Requirements

Requests for Certificates of Compliance should be directed to the issuing authority that issued the final Order of Conditions (OOC). If the project received an OOC from the Conservation Commission, submit this request to that Commission. If the project was issued a Superseding Order of Conditions or was the subject of an Adjudicatory Hearing Final Decision, submit this request to the appropriate DEP Regional Office (see <http://www.mass.gov/dep/about/region/findyour.htm>).

LAKE PEARL

ELEV. = 199.8 9/5/19
ELEV. = 197.4 2/24/20

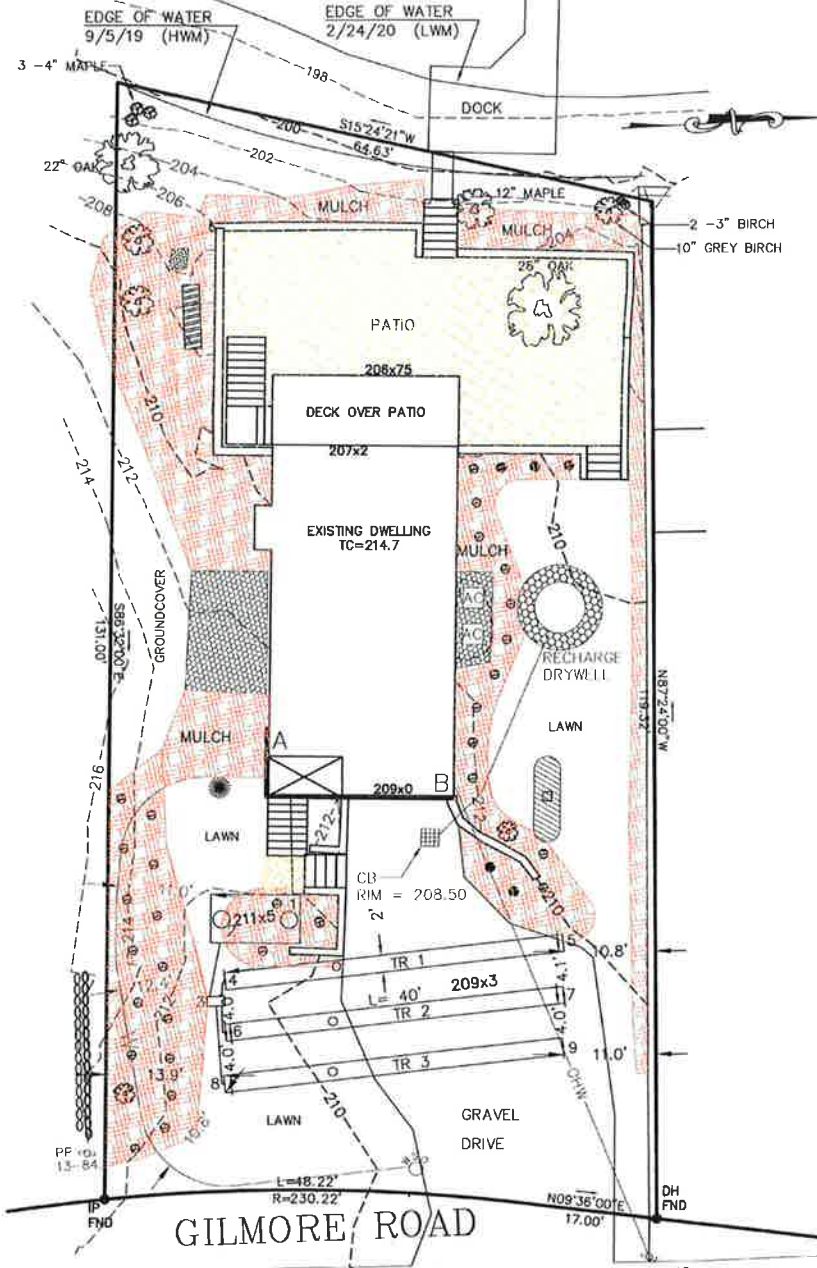

RECEIVED

JAN 14 2021


**WRENTHAM
CONSERVATION COMMISSION**

FINAL AS BUILT
137 GILMORE ROAD
WRENTHAM, MASSACHUSETTS
PREPARED FOR
CAROL FELIX
137 GILMORE ROAD
WRENTHAM, MASSACHUSETTS

**UNITED
CONSULTANTS
INC.**

850 FRANKLIN STREET SUITE 11D
WRENTHAM, MASSACHUSETTS 02093
508-384-6660 FAX 508-384-6666

DATE	JANUARY 6, 2021	PROJECT	UC 1423
SCALE	1" = 10'	SHEET	1 of 1
NO.	DATE	DESCRIPTION	BY

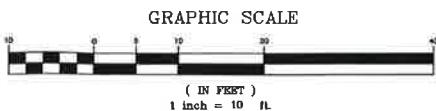

Carlos A. Quintal
CARLOS A. QUINTAL P.E. #30812